

Date: Wednesday, 5/31/2006 10:12:48 AM
 User: Kim Johnston

Process Sheet

Customer : CU-DAR001 Dart Helicopters Services	Drawing Name : 350 BASKET LID (SHORT)
Job Number : 27292B	
Estimate Number : 10210	
P.O. Number : N/A	Part Number : D3266041
This Issue : 5/31/2006 S.O. No. : N/A	Drawing Number : D3266-041 REV A1
Prsht Rev. : NC	Project Number : N/A
First Issue : 5/31/2006 Type : LARGE FAB ASSY	Drawing Revision : A1
Previous Run : 25094B	Material : N/A
Written By : <i>See Comment Below</i>	Due Date : 6/30/2006
Checked & Approved By : <i>06.05.31</i>	Qty: 1 Um: Each
Comment : Est Rev:B Re-Format 05-11-03 JLM	

Additional Product

Job Number:



Seq. #:	Machine Or Operation:	Description :
---------	-----------------------	---------------

1.0	D31663	Basket Hoop
-----	--------	-------------



Comment: Qty.: 1.0000 Each(s)/Unit Total : 1.0000 Each(s)

Pick:

Qty 1 D3166-3 Basket Hoop Batch: *B27327**AA06/06/12*

2.0	M304TS0750W065	304 SQ Tube.75x.75x.065W
-----	----------------	--------------------------



Comment: Qty.: 28.3500 f(s)/Unit Total : 28.3500 f(s)
 3/4" x 3/4" square tubing as per Dwg D3266Material: 304/316 SS tube .063" wall(
 M304TS0.750W.065)
 Batch: *M107111*

AA06/06/12

3.0	D22321	Hinge
-----	--------	-------



Comment: Qty.: 2.0000 Each(s)/Unit Total : 2.0000 Each(s)

Pick:

Qty Part Number	Description	Batch
2 D2232-1	Hinge plate	<i>B25238</i>

4.0	D23271	Spacer Bushing
-----	--------	----------------



Comment: Qty.: 2.0000 Each(s)/Unit Total : 2.0000 Each(s)

Pick:

Qty Part Number	Description	Batch
2 D2327-1	Bushing	<i>B26742</i>

W/O:		WORK ORDER CHANGES					
DATE	STEP	PROCEDURE CHANGE	By	Date	Qty	Approval Mfg / Design Mgr	Approval QC Inspector

NCR:		WORK ORDER NON-CONFORMANCE (NCR)						
DATE	STEP	Description of NC Section A	Corrective Action Section B			Verification Section C	Approval Design Mgr	Approval QC Inspector
			Initial Design Mgr	Action Description Design Mgr	Sign & Date			

Part No: _____ PAR #: _____ Fault Category: _____ NCR: Yes No DQA: _____ Date: _____

NOTE: Date & initial all entries

QA: N/C Closed: _____ Date: _____

Date: Wednesday, 5/31/2006 10:12:48 AM
User: Kim Johnston

Process Sheet

Customer: CU-DAR001 Dart Helicopters Services

Drawing Name: 350 BASKET LID (SHORT)

Job Number: 27292B

Part Number: D3266041

Job Number:



Seq. #:

Machine Or Operation:

Description :

5.0

D2506

Placard



Comment: Qty.: 1.0000 Each(s)/Unit Total : 1.0000 Each(s)

Pick:

Qty Part Number

Description Batch

1 D2506

Label Plate B26631-2

PD 06-06-16

6.0

D2581

Mounting Bracket



Comment: Qty.: 2.0000 Each(s)/Unit Total : 2.0000 Each(s)

Pick:

Qty Part Number

Description Batch

2 D2581

Mounting Bracket B266204

PD 06-06-16

7.0

M304EX07516F

Expanded Metal Flat Stai



Comment: Qty.: 10.0000 sf(s)/Unit Total : 10.0000 sf(s)

Pick:

Qty Part Number

Description Batch

10sf M304EX0.75-16F

Expanded Metal H100981

PD 06-06-21

8.0

LARGE FAB 1

LARGE FABRICATION RESOURCE 1



Comment: LARGE FABRICATION RESOURCE 1

1-Cut (4) D2236 From D3166-3

2-Cut 3/4" x 3/4" square tubing as per Dwg D3266

3-Drill holes in D3266-1 as per Dwg D3266 using Drill Jig DT8305

4-Deburr & Remove all markings from material

5-Weld as per Dwg D3266 using Welding Table and corner Jig Deburr as required

PD 06-06-21

W/O:		WORK ORDER CHANGES					
DATE	STEP	PROCEDURE CHANGE	By	Date	Qty	Approval Mfg / Design Mgr	Approval QC Inspector

NCR:		WORK ORDER NON-CONFORMANCE (NCR)						
DATE	STEP	Description of NC Section A	Corrective Action Section B			Verification Section C	Approval Design Mgr	Approval QC Inspector
			Initial Design Mgr	Action Description Design Mgr	Sign & Date			

Part No: _____ PAR #: _____ Fault Category: _____ NCR: Yes ☐ No ☒ DQA: LD Date: 06/06/27

NOTE: Date & initial all entries

QA: N/C Closed: _____ Date: _____

Date: Wednesday, 5/31/2006 10:12:48 AM
User: Kim Johnston

Process Sheet

Customer: CU-DAR001 Dart Helicopters Services

Drawing Name: 350 BASKET LID (SHORT)

Job Number: 27292B

Part Number: D3266041

Job Number:



Seq. #:

Machine Or Operation:

Description :

9.0

QC9/6

DDIMENSIONAL & WELDING INSPECTION



Comment: DDIMENSIONAL & WELDING INSPECTION

DL 06/06/21 ⑤

10.0

POWDER COATING

POWDER COATING



Comment: POWDER COATING

Powder Coat White Gloss (Ref: 4.3.5.1) as per QSI 005 4.3

DL 06/06/22 ①

11.0

HAND FINISHING1

HAND FINISHING RESOURCE #1



Comment: HAND FINISHING RESOURCE #1

Wing Walk Batch: M101266

and Spray Paint black Batch: M101032

as per Dwg D3266 and QSI 005 4.4

FC 06 06 22 ①

12.0

QC3

INSPECT POWDER COAT/CHEMICAL CONVERSION



Comment: Inspect Powder Coat and Wing Walk

SB 06/06/23 ①

13.0

DC

DOCUMENT CONTROL



Comment: DOCUMENT CONTROL

Inspection Level 21

DL 06/06/27 ②

Job Completion



W 06/06/26

W/O:		WORK ORDER CHANGES					
DATE	STEP	PROCEDURE CHANGE	By	Date	Qty	Approval Mfg / Design Mgr	Approval QC Inspector

NCR:		WORK ORDER NON-CONFORMANCE (NCR)						
DATE	STEP	Description of NC Section A	Corrective Action Section B			Verification Section C	Approval Design Mgr	Approval QC Inspector
			Initial Design Mgr	Action Description Design Mgr	Sign & Date			

Part No: _____ PAR #: _____ Fault Category: _____ NCR: Yes No DQA: _____ Date: _____

NOTE: Date & initial all entries

QA: N/C Closed: _____ Date: _____




DESIGN <i>[Signature]</i>	DRAWN BY <i>[Signature]</i>	DART AEROSPACE LTD HAWKESBURY, ONTARIO, CANADA	
CHECKED <i>[Signature]</i>	APPROVED <i>[Signature]</i>	DRAWING NO. D3266	REV. A SHEET 1 OF 4
DATE 04.02.02		TITLE BASKET LID ASSEMBLY (350)	SCALE NTS
A	04.02.02	NEW ISSUE	
A1	<i>[Signature]</i> 04.09.20	TACK WELD ANTI-SKID AREA	

RELEASED
04.02.10 *[Signature]*

PARTS LIST FOR D3266-041 BASKET LID ASSEMBLY

PART NO	QUANTITY	LENGTH A	LENGTH B	DESCRIPTION
D3266-1	2	—	25.50	RIB
D3266-3	2	—	56.17	RIB
D3266-5	6	11.27	—	RIB
D3266-7	3	30.63	—	RIB
D2232-1	2	N/A	N/A	HINGE PLATE
D2236	4	N/A	N/A	RIB
D2327-1	2	N/A	N/A	BUSHING
D2506	1	N/A	N/A	LABEL PLATE
D2581	2	N/A	N/A	MOUNTING BRKT

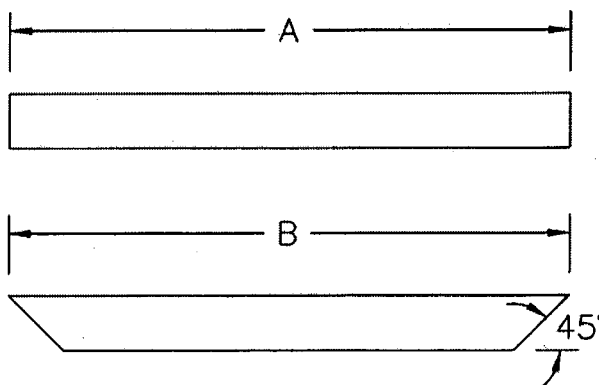

SHOP COPY
RETURN TO
ENGINEERING
UNCONTROLLED COPY
SUBJECT TO AMENDMENT
WITHOUT NOTICE
WORK ORDER
NO. *27292B*

D3266-1/-3/-5/-7

- 1) CUT LENGTH/SHAPE PER DIAGRAM AND PARTS LIST
- 2) MATERIAL: AISI 304/316 SS, 3/4 X 3/4 X 0.060 WALL SQUARE TUBING
- 3) TOLERANCES ARE PER DART QSI 018 UNLESS OTHERWISE NOTED
- 4) ALL DIMENSIONS ARE IN INCHES

Copyright © 2004 by DART AEROSPACE LTD


THIS DOCUMENT IS PRIVATE AND CONFIDENTIAL AND IS SUPPLIED ON THE EXPRESS CONDITION THAT IT IS NOT TO BE USED FOR ANY PURPOSE OR COPIED OR COMMUNICATED TO ANY OTHER PERSON WITHOUT WRITTEN PERMISSION FROM DART AEROSPACE LTD.

DART



DESIGN	DRAWN BY	DART AEROSPACE LTD
CHECKED	APPROVED	HAWKESBURY, ONTARIO, CANADA
DATE	TITLE	REV. A
04.02.02	D3266	SHEET 2 OF 4
	BASKET LID ASSEMBLY (350)	SCALE 1:20

RELEASED
04.02.02

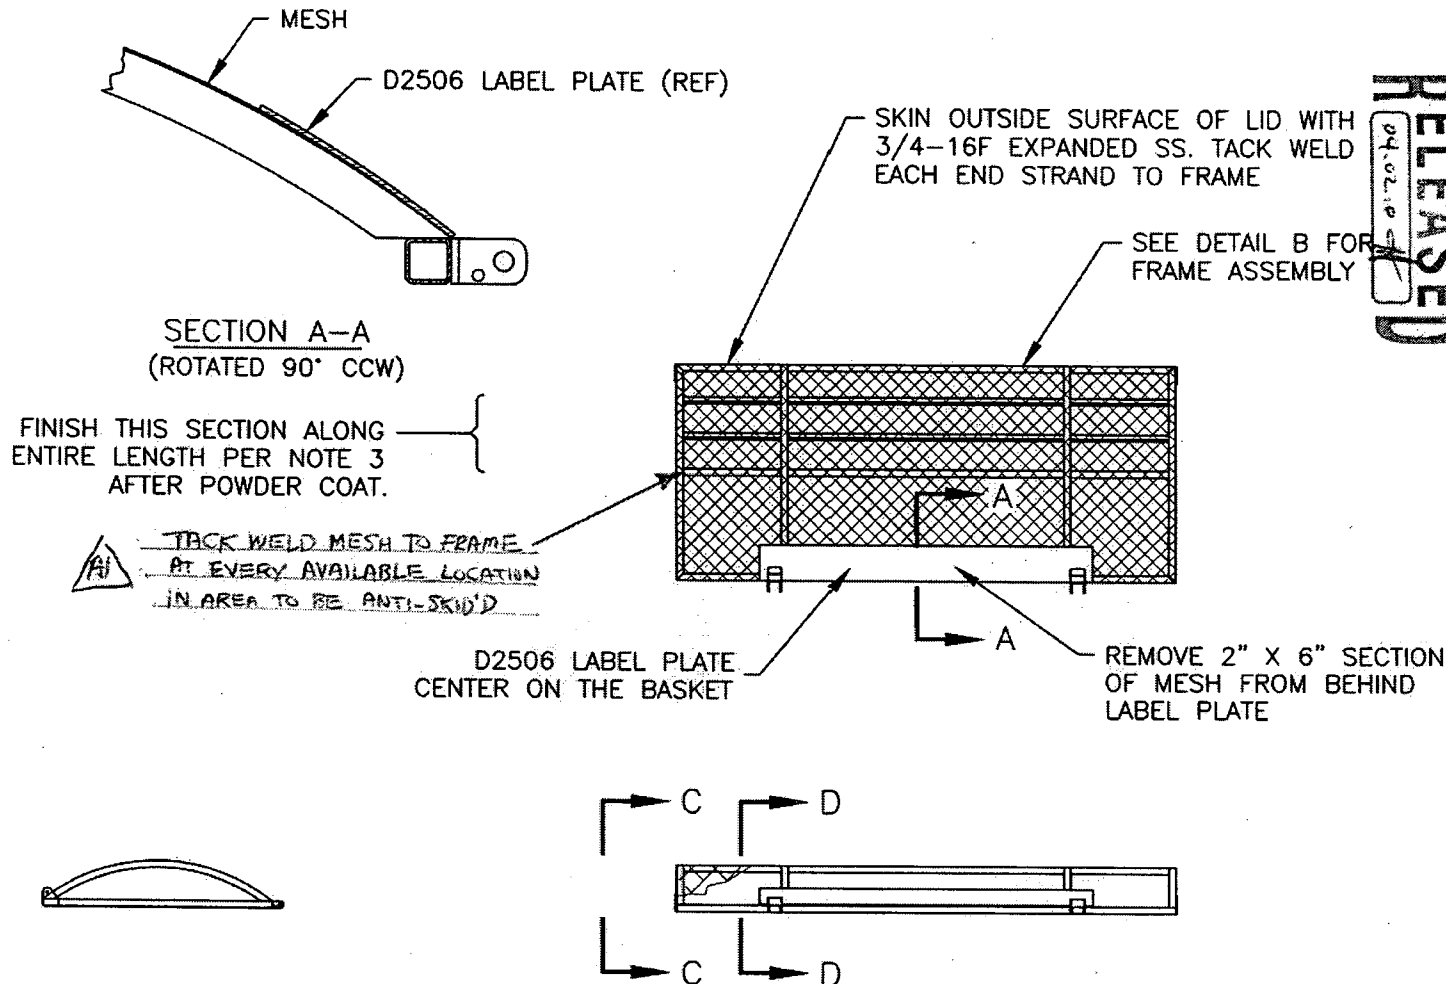

D3266-041 BASKET LID ASSEMBLY

- 1) MESH MATERIAL: 3/4-16F EXPANDED SS
- 2) FINISH: POWDER COAT ENTIRE ASSEMBLY WHITE (4.3.5.2) PER DART QSI 005 4.3
- 3) SPRAY PAINT BLACK INSIDE SURFACE
APPLY BLACK ANTI-SKID TO OUTSIDE SURFACE PER DART QSI 005 4.4
- 4) TOLERANCES ARE PER DART QSI 018 UNLESS OTHERWISE NOTED
- 5) ALL DIMENSIONS ARE IN INCHES


SHOP COPY
RETURN TO
ENGINEERING
UNCONTROLLED COPY
SUBJECT TO AMENDMENT
WITHOUT NOTICE

WORK ORDER
NO. 27292 B



DESIGN <i>[Signature]</i>	DRAWN BY <i>[Signature]</i>	DART AEROSPACE LTD HAWKESBURY, ONTARIO, CANADA	
CHECKED <i>[Signature]</i>	APPROVED <i>[Signature]</i>	DRAWING NO. D3266	REV. A SHEET 3 OF 4
DATE 04.02.02		TITLE BASKET LID ASSEMBLY (350)	SCALE 1:20

RELEASED
04.02.10

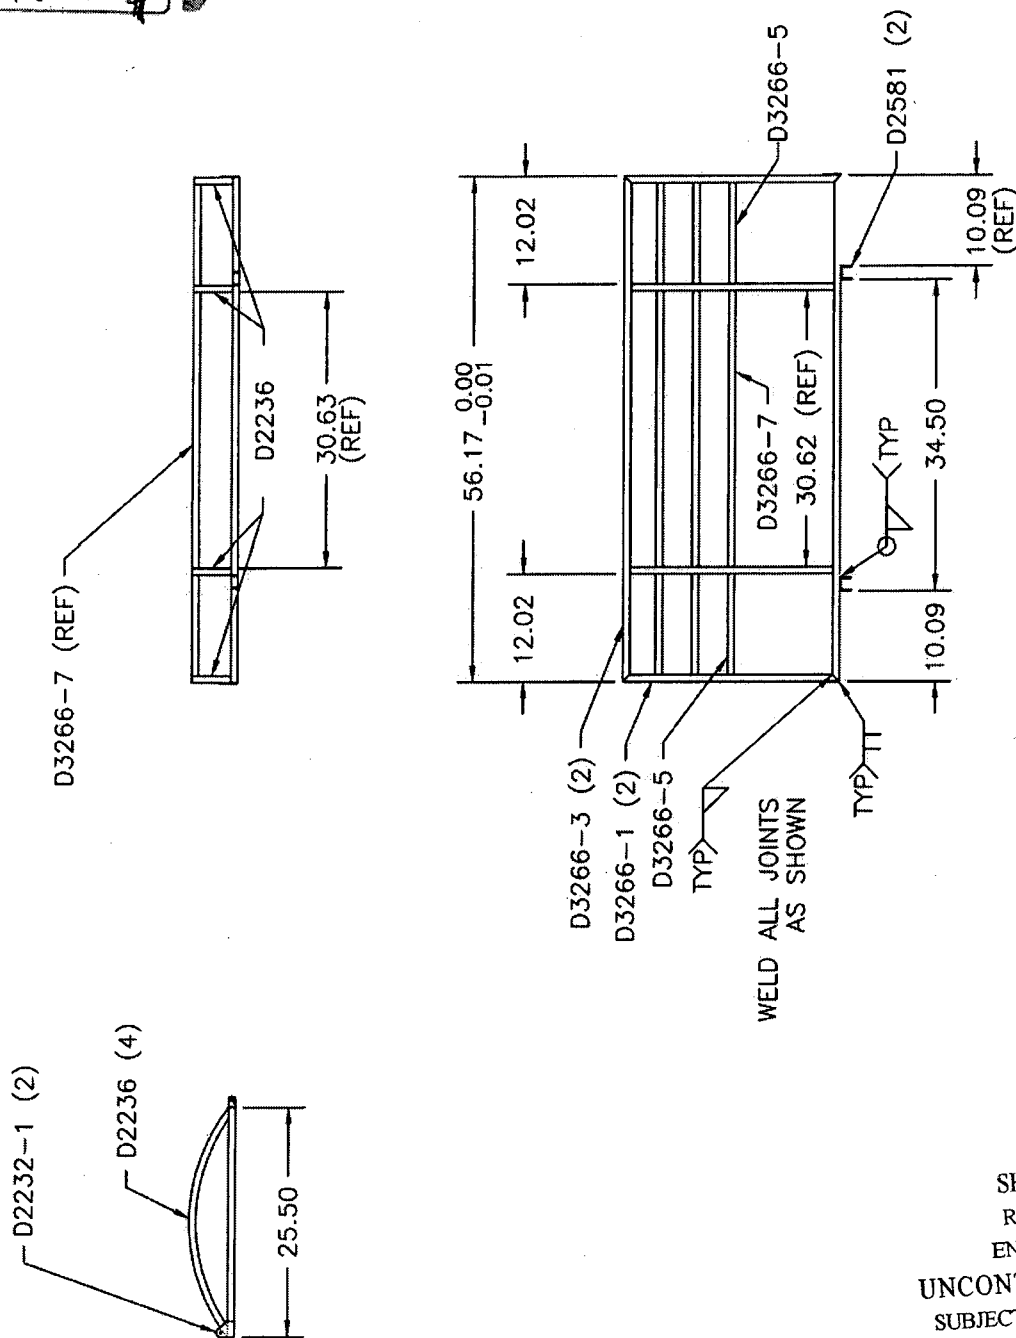

DETAIL B
FRAMEWORK SHOWN FOR CLARITY
TOLERANCES ARE PER DART QSI 018 UNLESS OTHERWISE NOTED
ALL DIMENSIONS ARE IN INCHES

SHOP COPY
RETURN TO
ENGINEERING
UNCONTROLLED COPY
SUBJECT TO AMENDMENT
WITHOUT NOTICE
WORK ORDER
NO. 27292B


Copyright © 2004 by DART AEROSPACE LTD

THIS DOCUMENT IS PRIVATE AND CONFIDENTIAL AND IS SUPPLIED ON THE EXPRESS CONDITION THAT IT IS NOT TO BE USED FOR ANY PURPOSE OR COPIED OR COMMUNICATED TO ANY OTHER PERSON WITHOUT WRITTEN PERMISSION FROM DART AEROSPACE LTD.




DESIGN #	DRAWN BY UP	DART AEROSPACE LTD HAWKESBURY, ONTARIO, CANADA	
CHECKED #	APPROVED #	DRAWING NO. D3266	REV. A SHEET 4 OF 4
DATE 04.02.02		TITLE BASKET LID ASSEMBLY (350)	SCALE 1:8


RELEASED
04.02.10 #

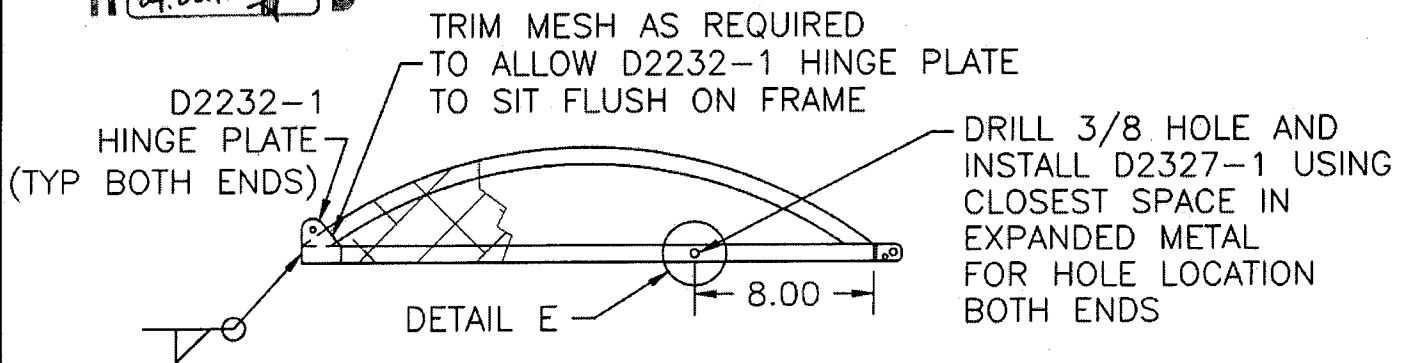

SECTION C-C SIMILIAR BOTH END RIBS

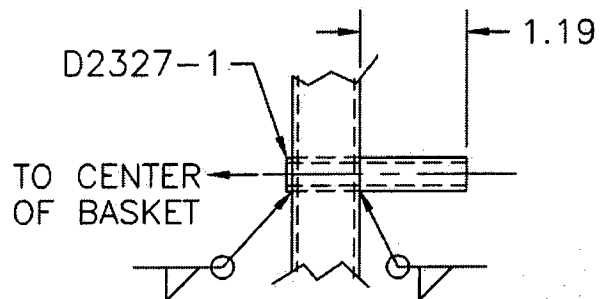

DETAIL E

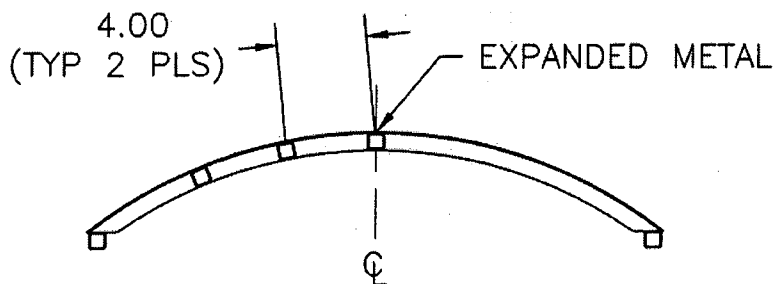

SECTION D-D SAME BOTH CENTER RIBS

SHOP COPY
RETURN TO
ENGINEERING
UNCONTROLLED COPY
SUBJECT TO AMENDMENT
WITHOUT NOTICE
WORK ORDER
NO. 27292 B

Copyright © 2004 by DART AEROSPACE LTD


THIS DOCUMENT IS PRIVATE AND CONFIDENTIAL AND IS SUPPLIED ON THE EXPRESS CONDITION THAT IT IS NOT TO BE USED FOR ANY PURPOSE OR COPIED OR COMMUNICATED TO ANY OTHER PERSON WITHOUT WRITTEN PERMISSION FROM DART AEROSPACE LTD.



DESIGN BW	DRAWN BY PH	DART AEROSPACE LTD HAWKESBURY, ONTARIO, CANADA	
CHECKED #	APPROVED #	DRAWING NO. D2236	REV. C SHEET 1 OF 1
DATE 05.06.07		TITLE LID RIB	SCALE 1:4
A	94.05.30	NEW ISSUE	
B	94.12.16	LID	
C	05.06.07	UPDATE NOTES, CHANGE RADIUS TO 19.0	

RELEASED

05-08-19 #

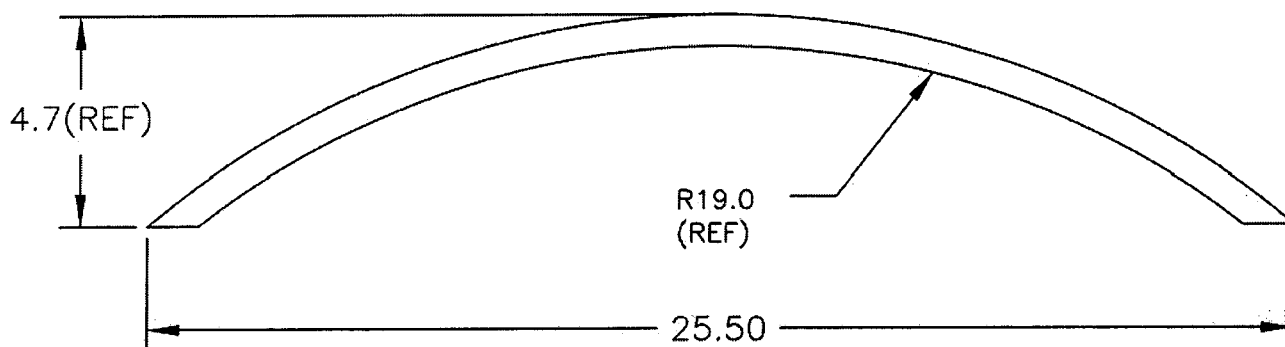

D2236

D2236 LID RIB

- 1) MAKE FROM D3166-3 BASKET HOOP
- 2) FINISH: NONE
- 3) ALL DIMENSIONS ARE IN INCHES
- 4) ALL TOLERANCES AER PER DART QSI 018 UNLESS OTHERWISE NOTED

SHOP COPY
RETURN TO
ENGINEERING
UNCONTROLLED COPY
SUBJECT TO AMENDMENT
WITHOUT NOTICE

WORK ORDER
NO. 27292B

Copyright © 1994 by DART AEROSPACE LTD

THIS DOCUMENT IS PRIVATE AND CONFIDENTIAL AND IS SUPPLIED ON THE EXPRESS CONDITION THAT IT IS NOT TO BE USED FOR ANY PURPOSE OR COPIED OR COMMUNICATED TO ANY OTHER PERSON WITHOUT WRITTEN PERMISSION FROM DART AEROSPACE LTD.